



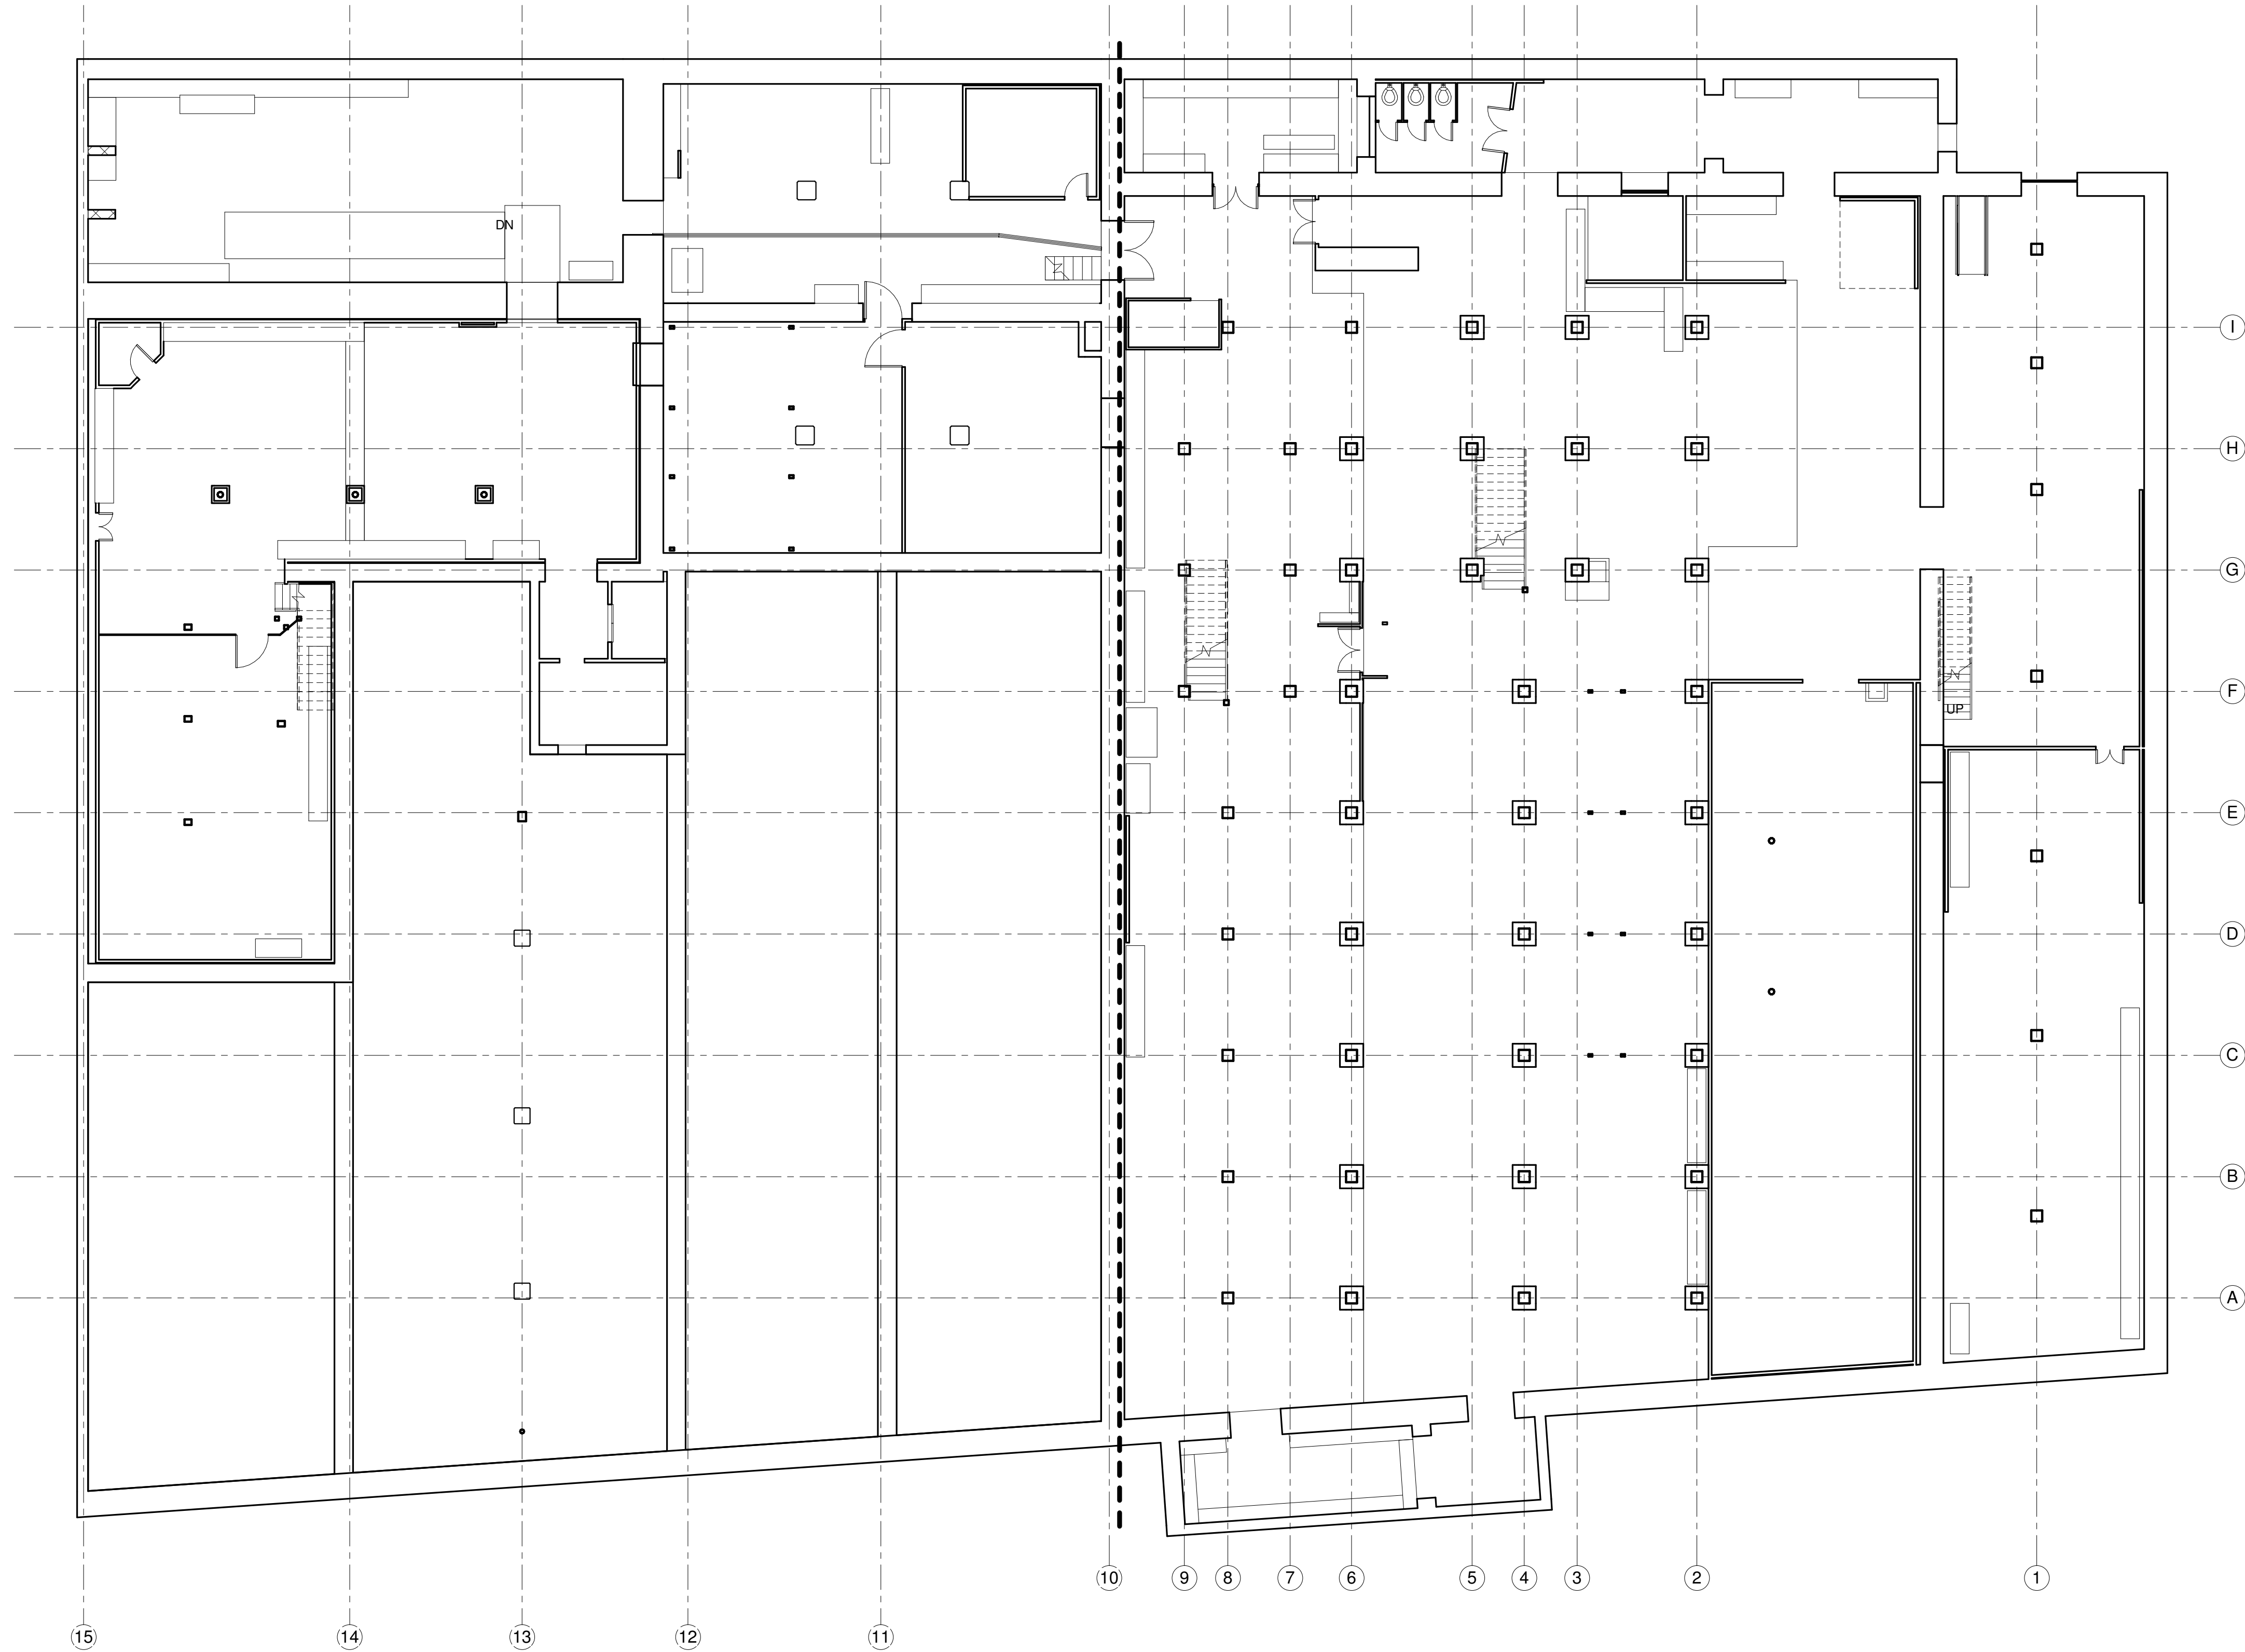

1 BASEMENT
X101 3/32" = 1'-0"

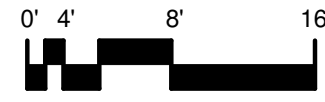

NOT FOR CONSTRUCTION

REVISIONS

A Historical Renovation For:
The Missoula Mercantile Building
110 N. Higgins Ave. Missoula, MT


AS-BUILTS

COPYRIGHT 2011
CTA, INC.
ALL RIGHTS RESERVED.
DRAWN BY: Author
CHECKED BY: Checker
DATE: 01/23/12
CTA # MERC



EXISTING
BASEMENT
FLOOR PLAN

SHEET
X101

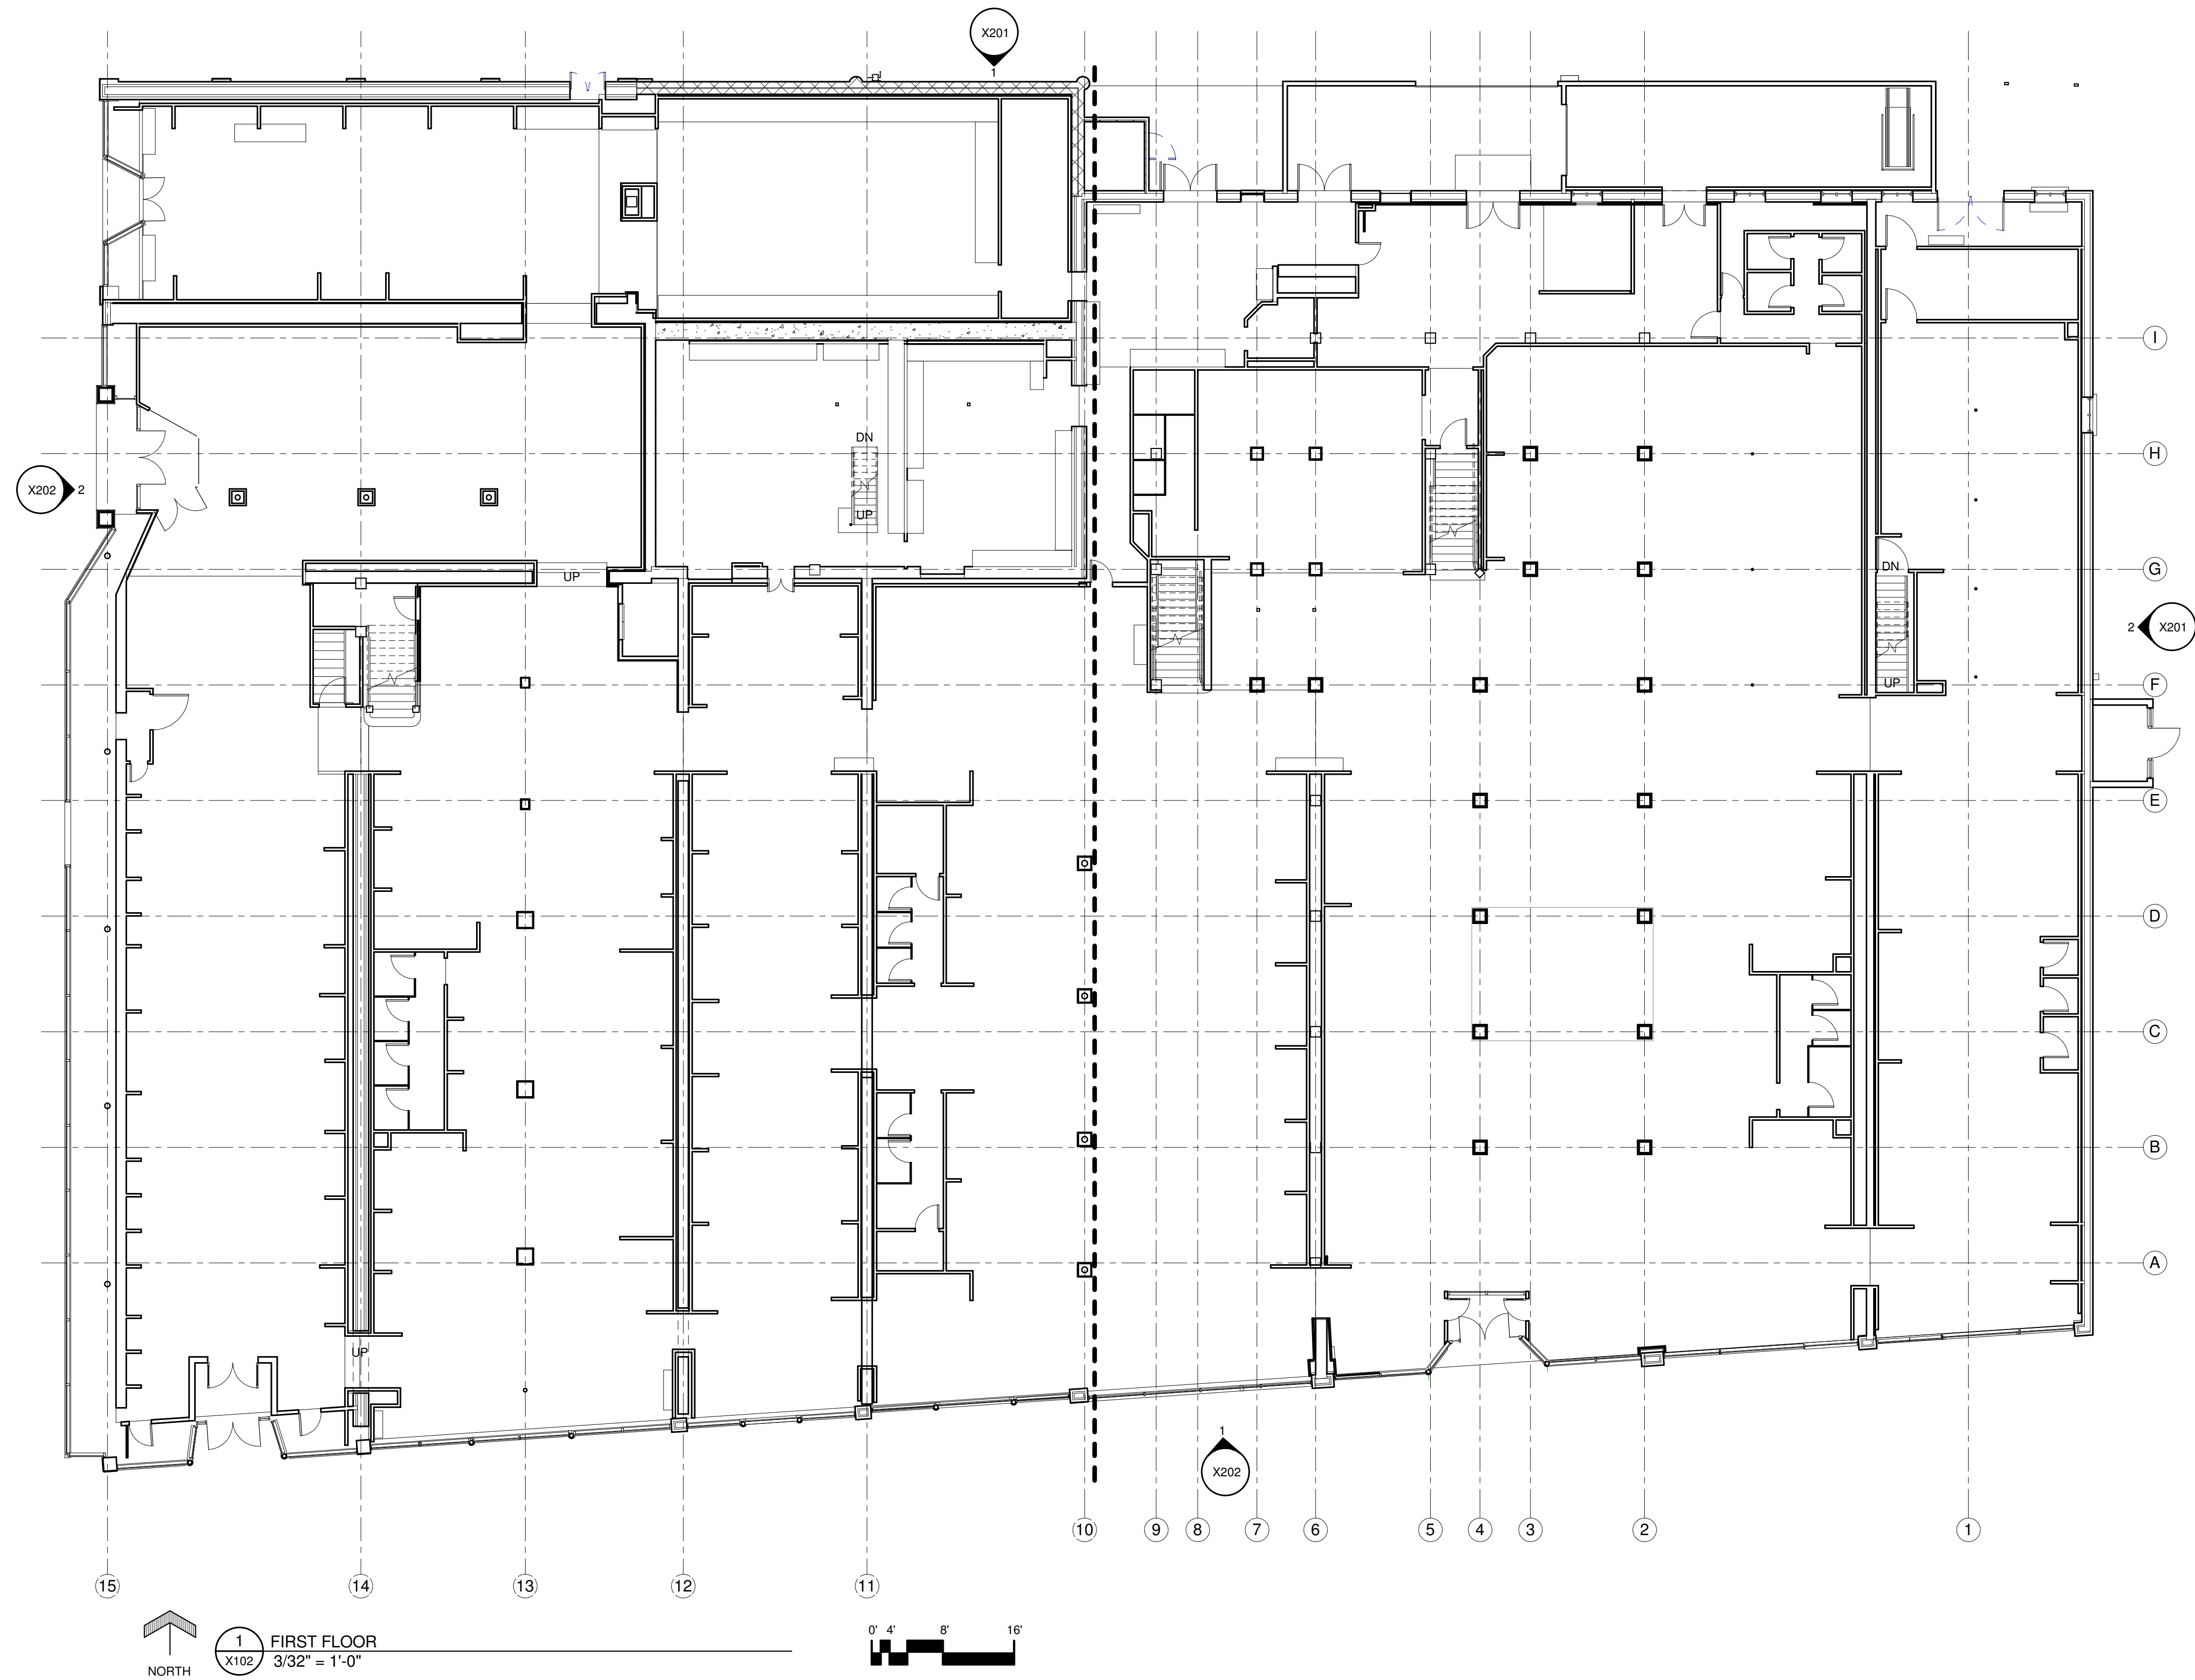

NOT FOR CONSTRUCTION

REVISIONS

A Historical Renovation For:
The Missoula Mercantile Building
110 N. Higgins Ave. Missoula, MT

AS-BUILTS


COPYRIGHT 2011
CTA, INC.
ALL RIGHTS RESERVED.
DRAWN BY: Author
CHECKED BY: Checker
DATE: 01/23/12
CTA # MERC



EXISTING
FIRST FLOOR
PLAN

SHEET

X102

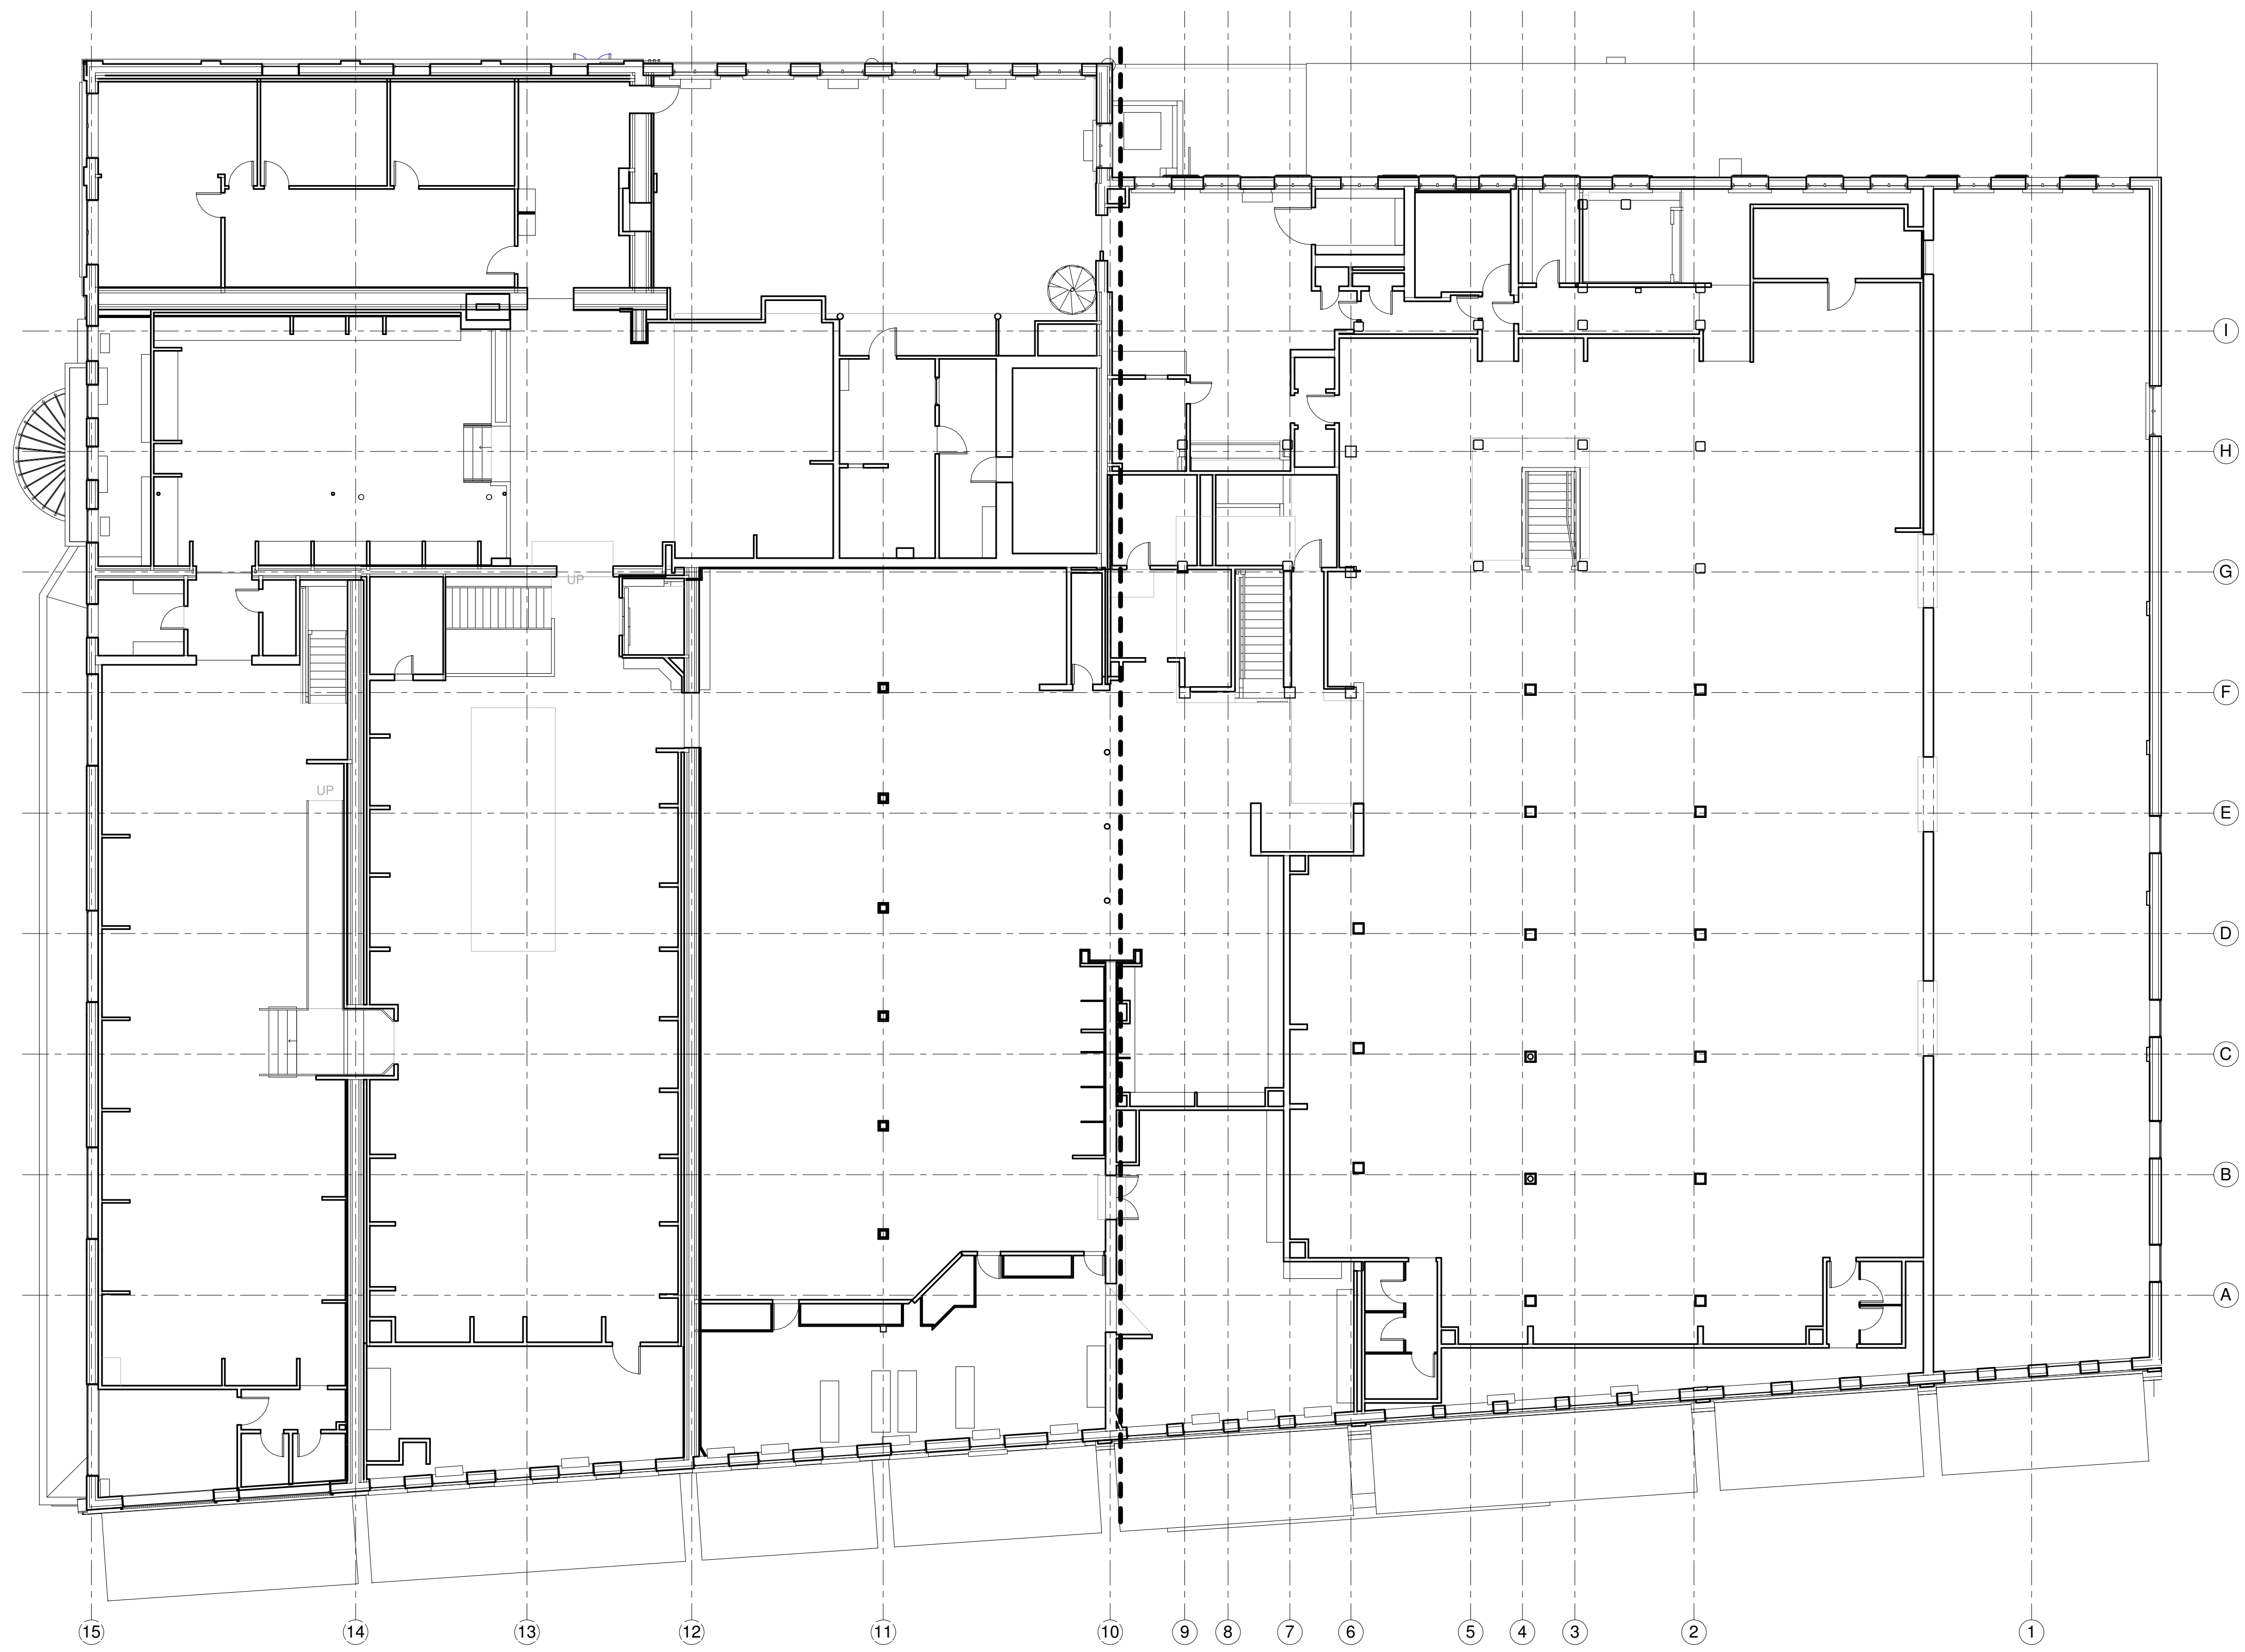

NORTH
1 SECOND FLOOR
X103 3/32" = 1'-0"


NOT FOR CONSTRUCTION

REVISIONS

A Historical Renovation For:
The Missoula Mercantile Building
110 N. Higgins Ave. Missoula, MT

AS-BUILTS

COPYRIGHT 2011
CTA, INC.
ALL RIGHTS RESERVED.
DRAWN BY: Author
CHECKED BY: Checker
DATE: 01/23/12
CTA # MERC

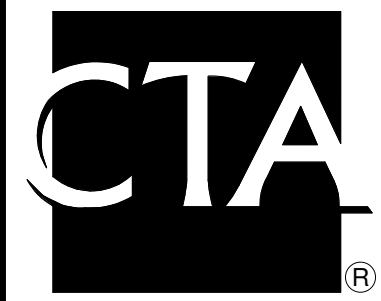


EXISTING
SECOND
FLOOR PLAN

SHEET


X103



1 MEZZANINE
X104 3/32" = 1'-0"

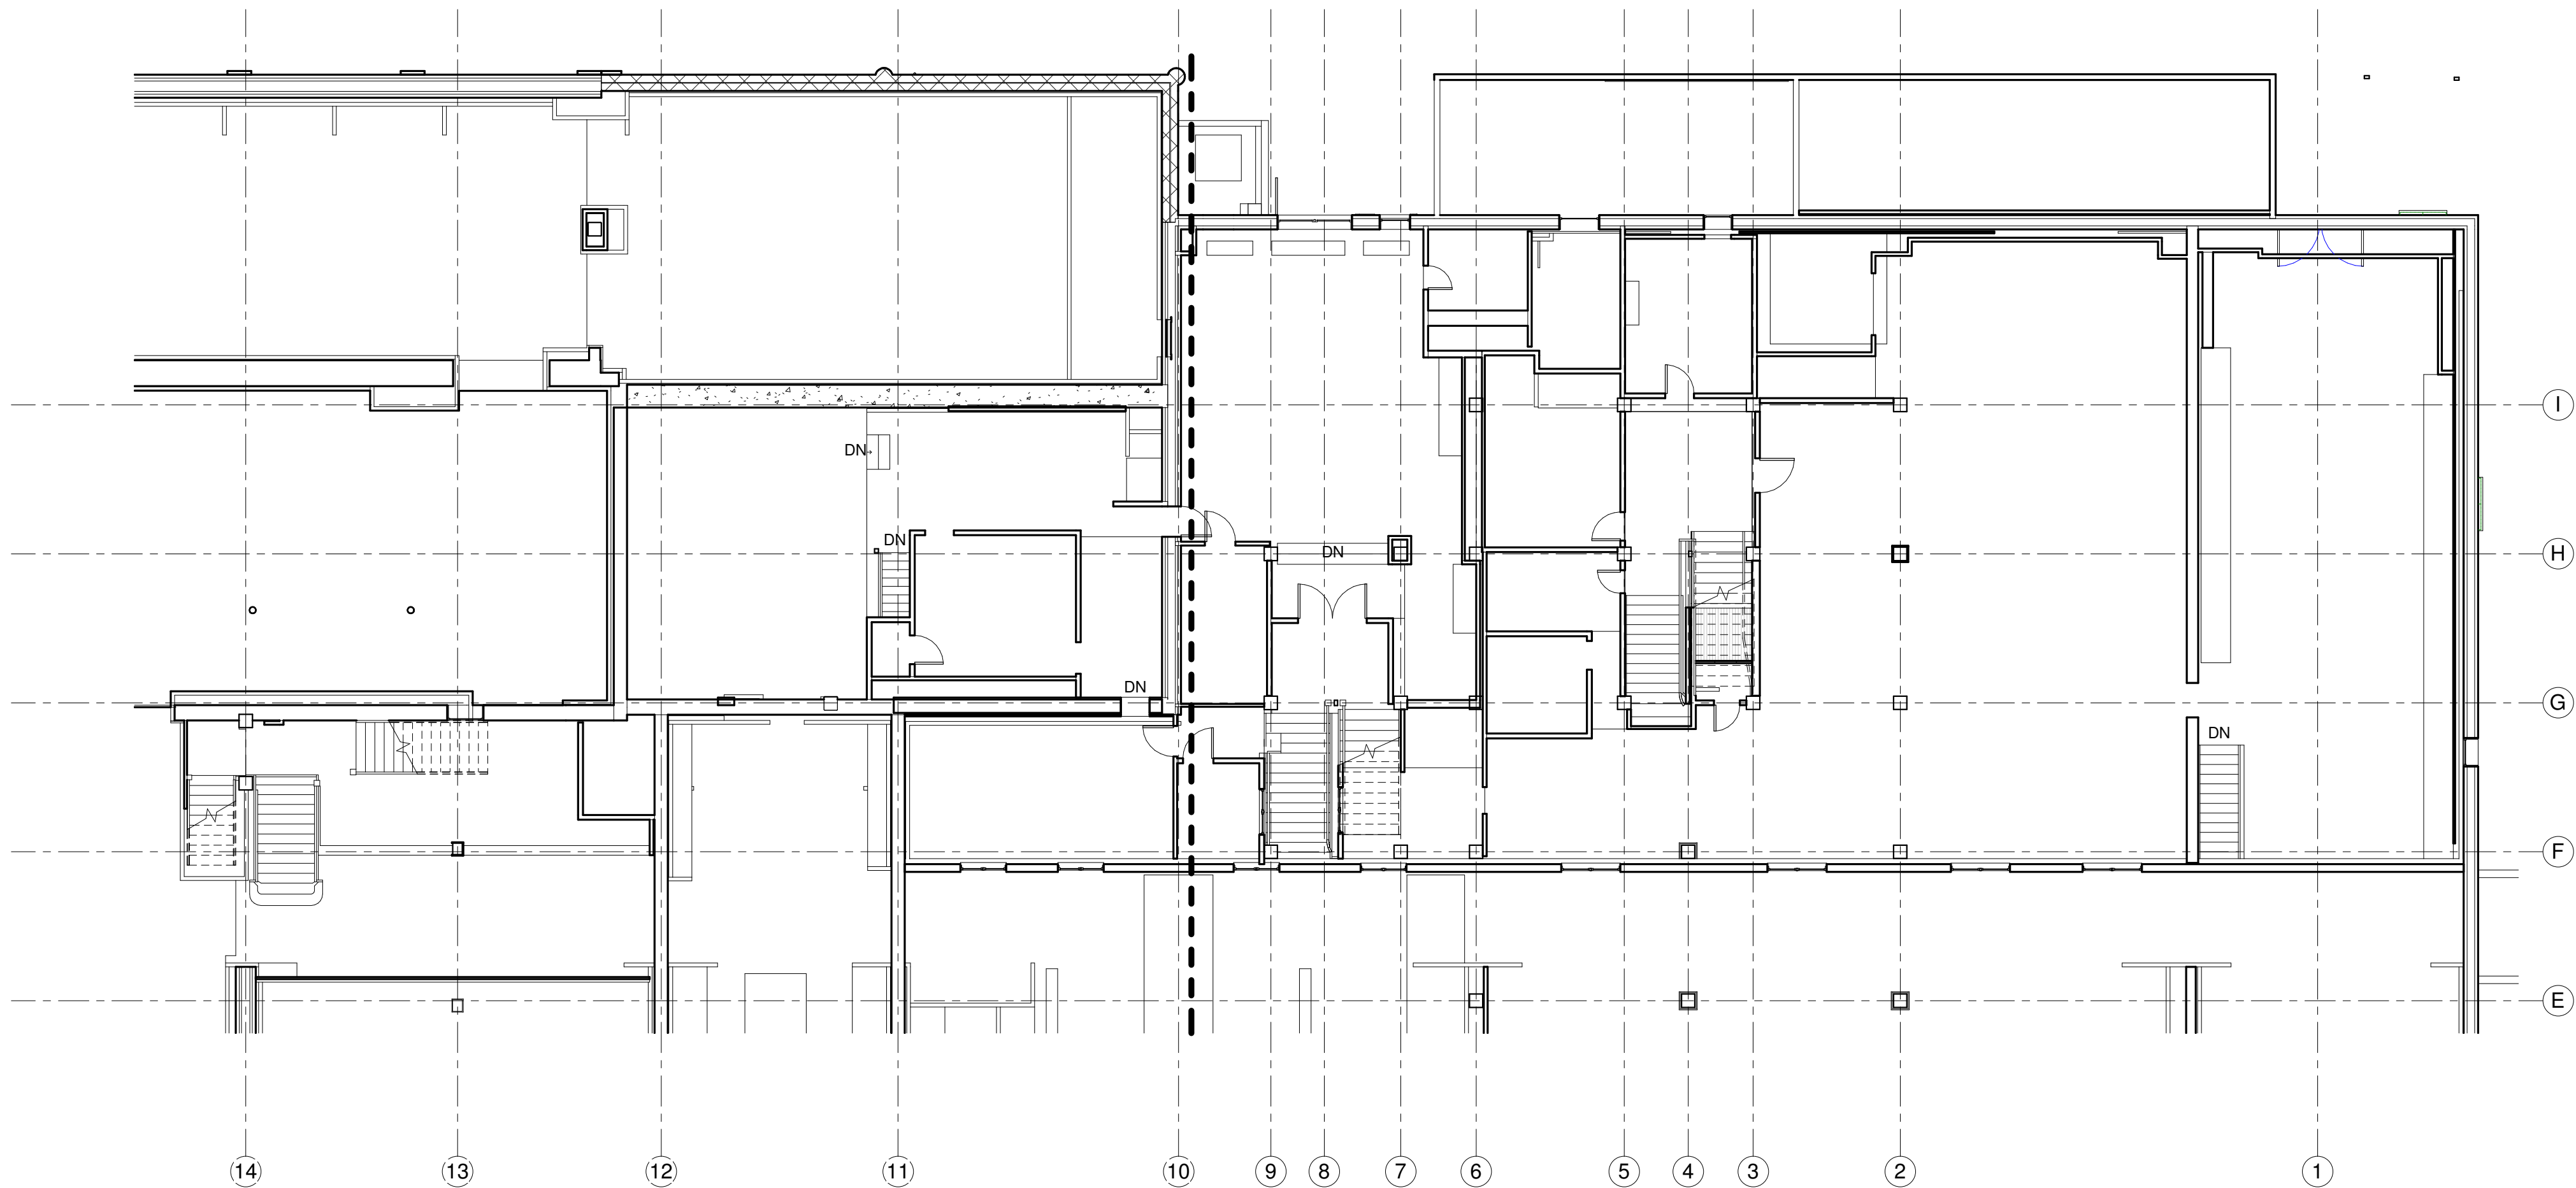

2 PENTHOUSE
X104 3/32" = 1'-0"

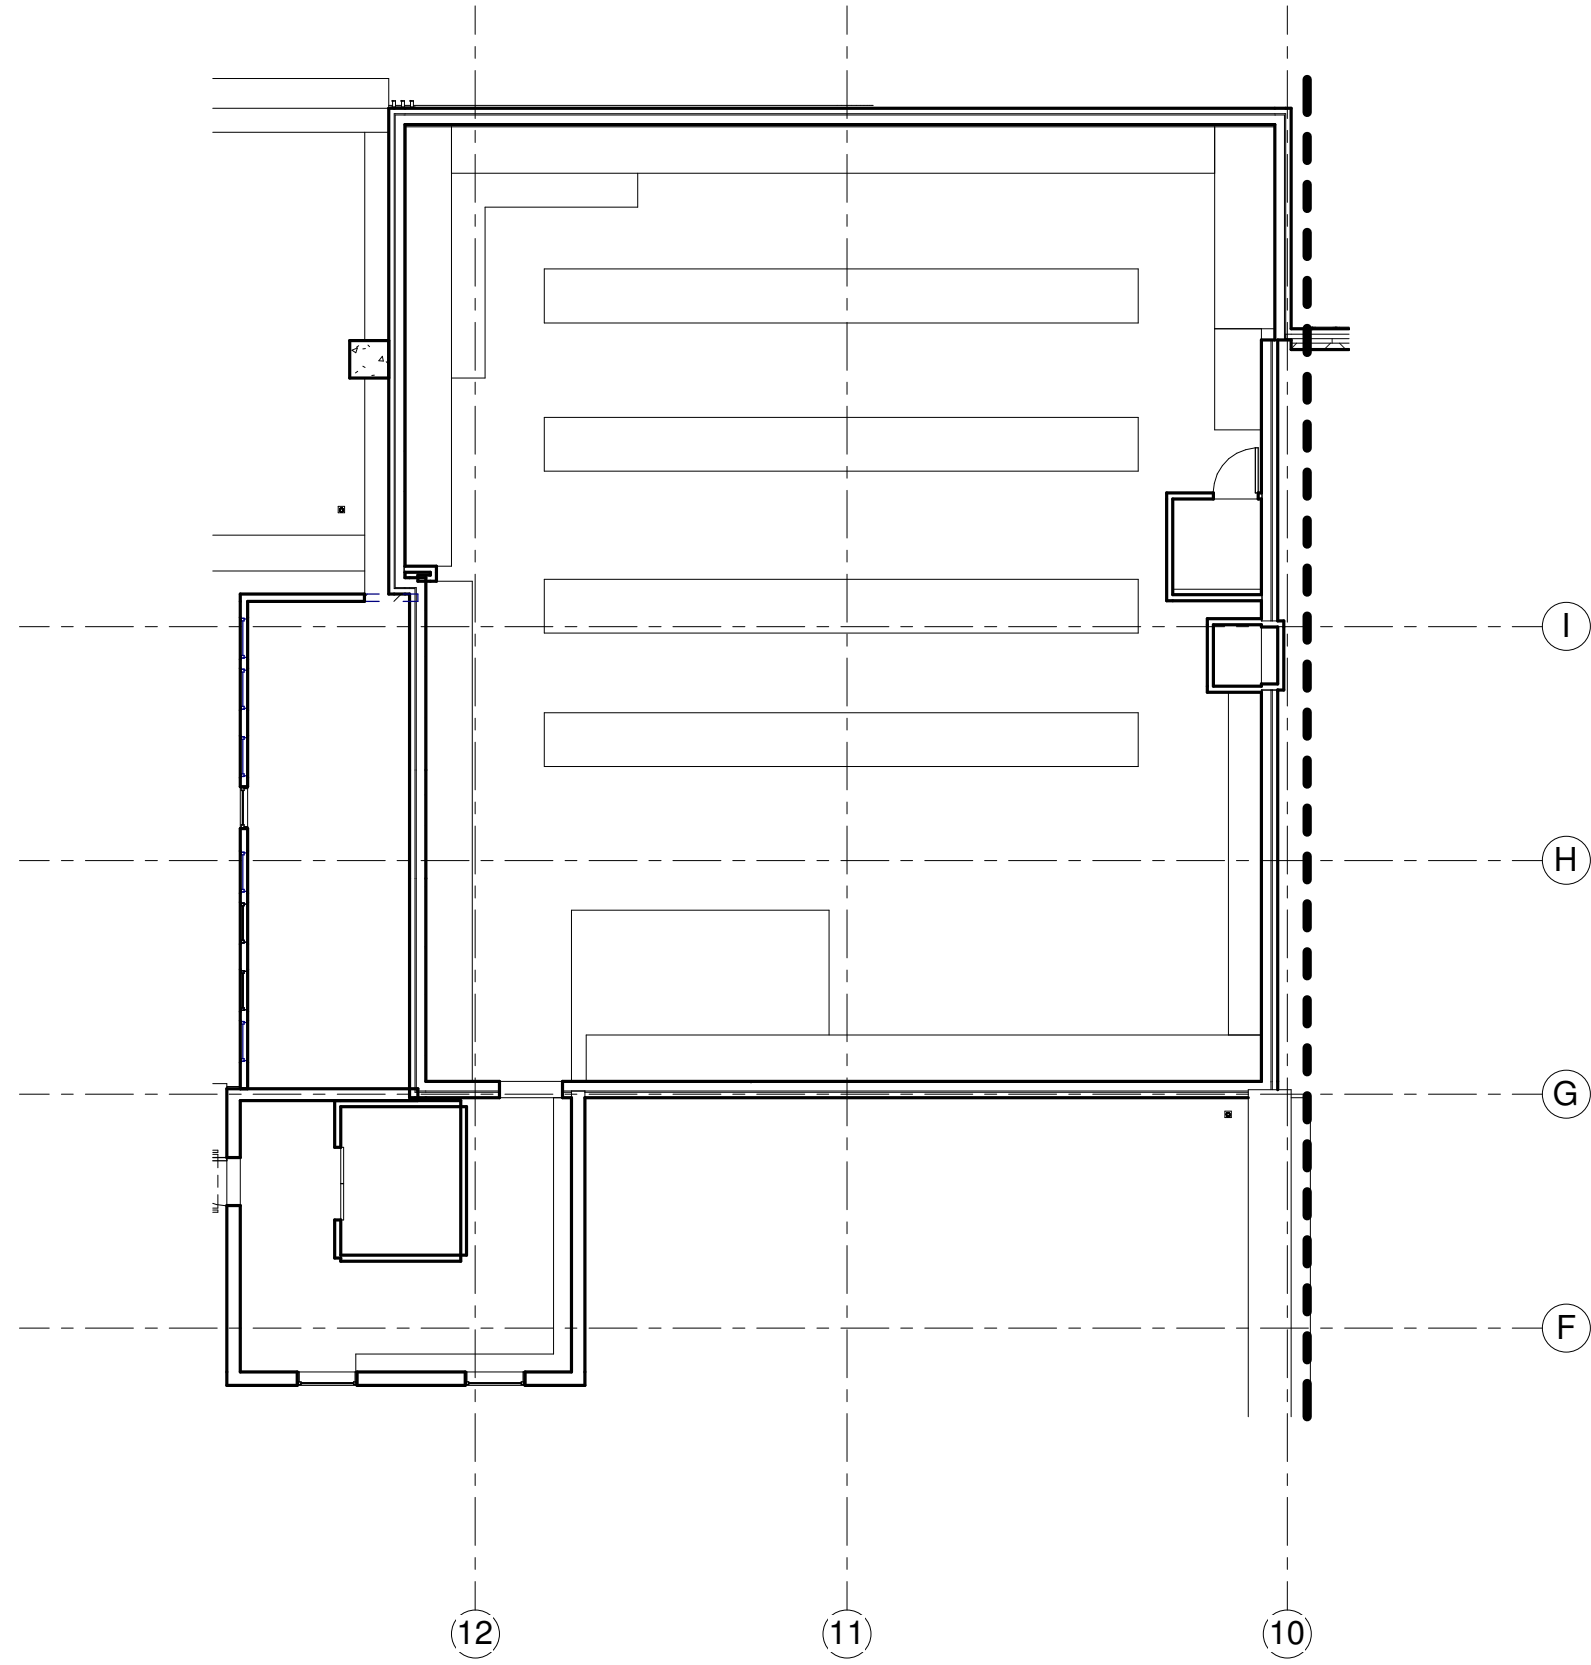

NOT FOR CONSTRUCTION

REVISIONS

A Historical Renovation For:
The Missoula Mercantile Building
110 N. Higgins Ave. Missoula, MT


AS-BUILTS

COPYRIGHT 2011
CTA, INC.
ALL RIGHTS RESERVED.
DRAWN BY: Author
CHECKED BY: Checker
DATE: 01/23/12
CTA # MERC



EXISTING
MEZZANINE &
PENTHOUSE
PLAN

SHEET
X104

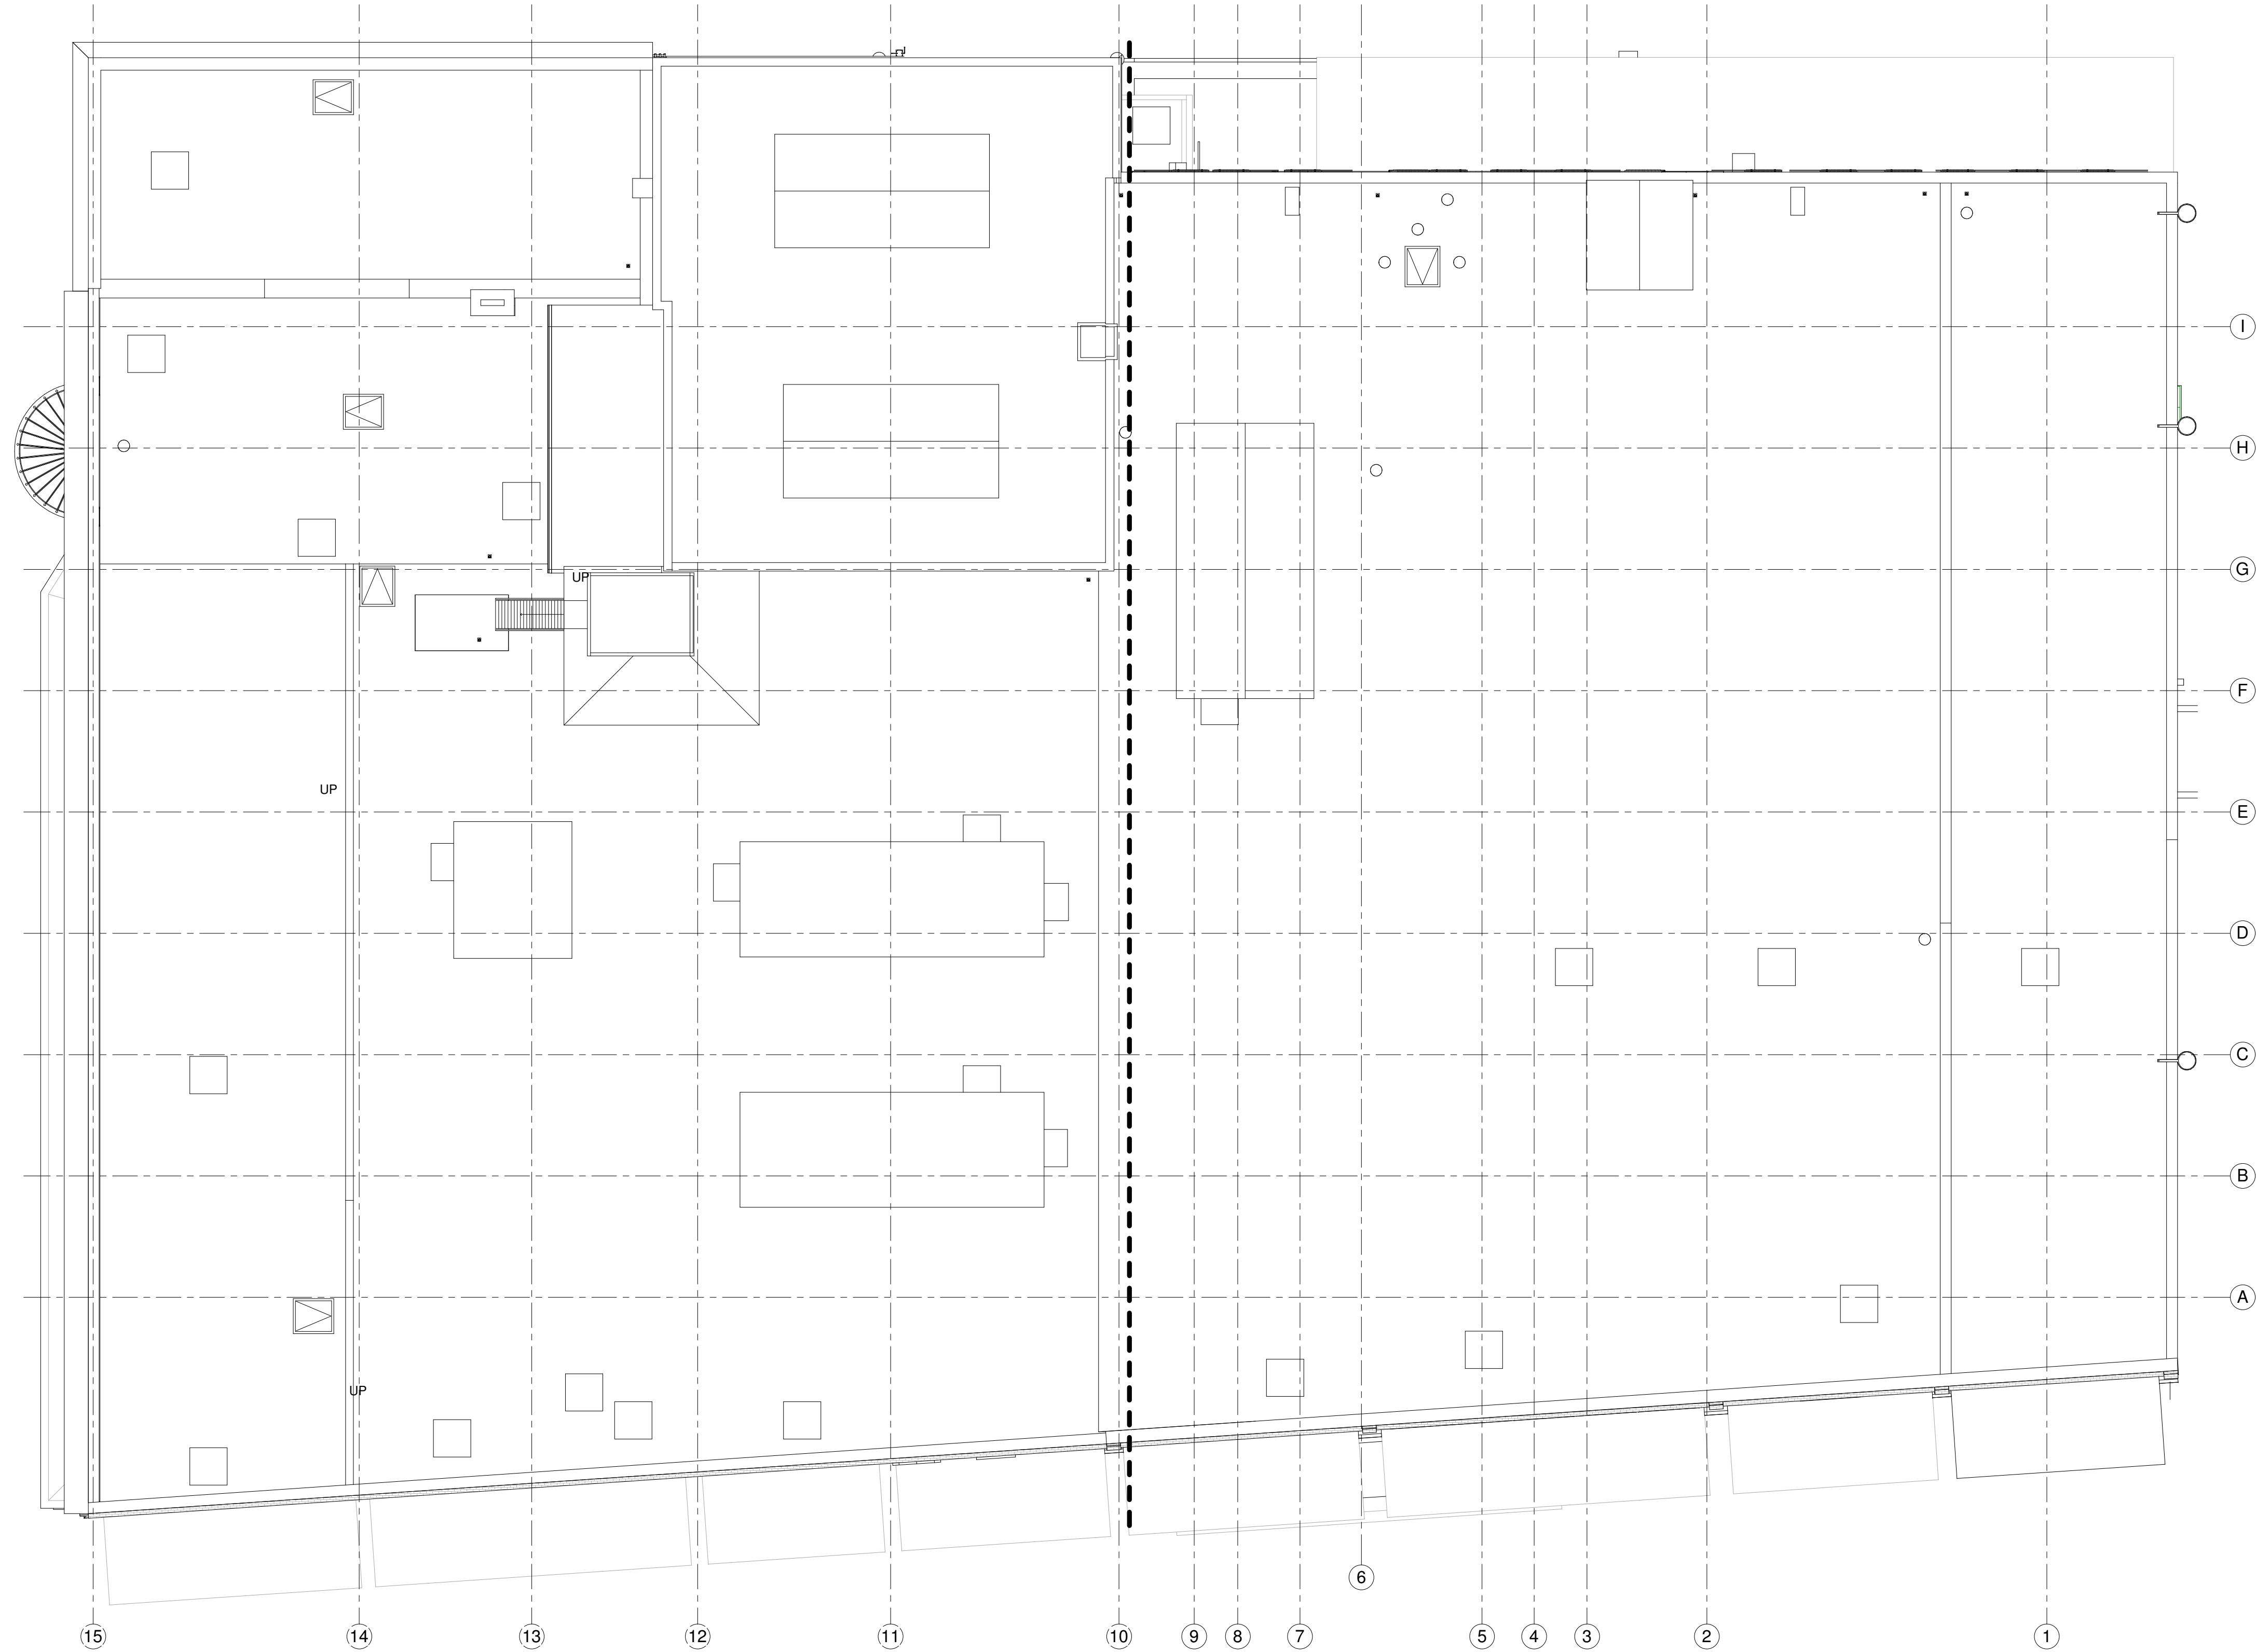

1 ROOF
X105 3/32" = 1'-0"

NOT FOR CONSTRUCTION

REVISIONS

A Historical Renovation For:
The Missoula Mercantile Building
110 N. Higgins Ave. Missoula, MT

AS-BUILTS

COPYRIGHT 2011
CTA, INC.
ALL RIGHTS RESERVED.
DRAWN BY: Author
CHECKED BY: Checker
DATE: 01/23/12
CTA # MERC




EXISTING
ROOF PLAN

SHEET

X105



1 NORTH
X201 3/32" = 1'-0"

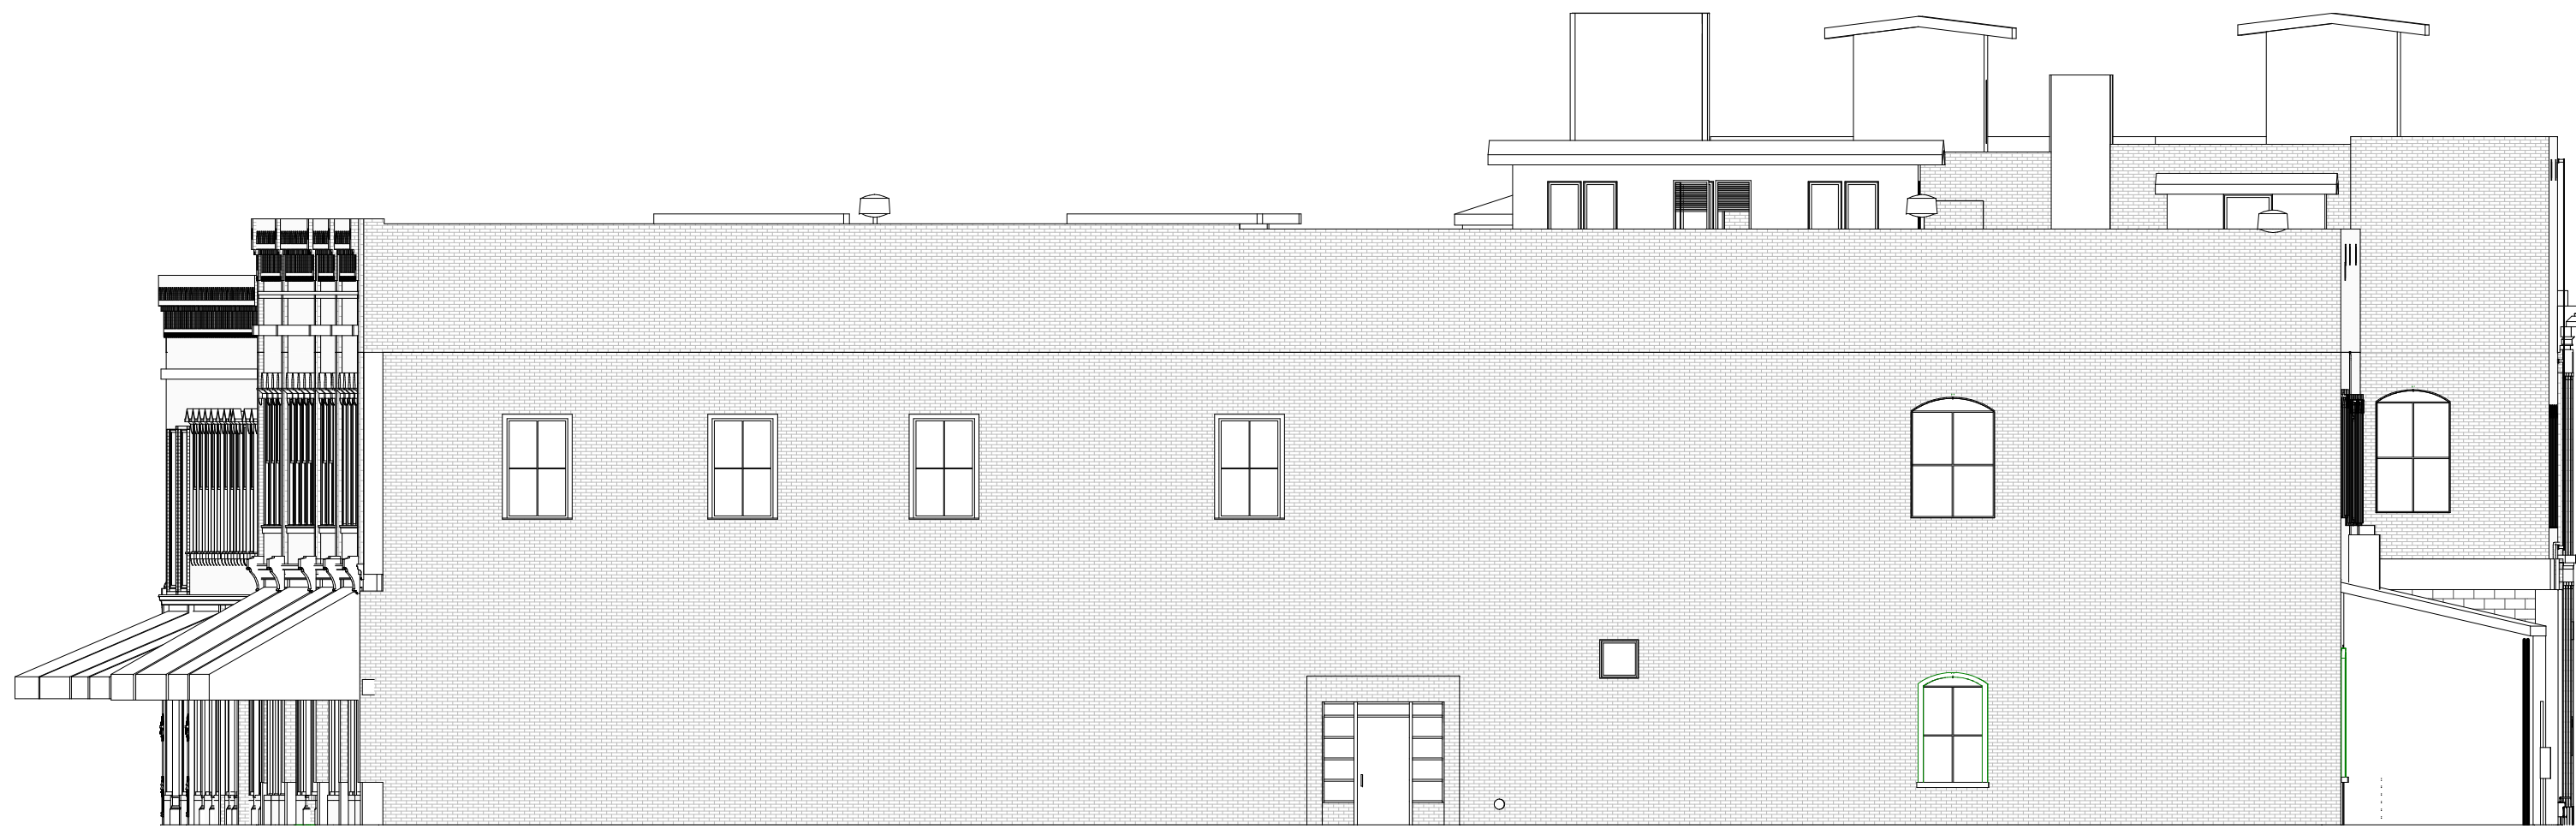

2 EAST
X201 3/32" = 1'-0"



NOT FOR CONSTRUCTION

REVISIONS

A Historical Renovation For:
The Missoula Mercantile Building
110 N. Higgins Ave. Missoula, MT

AS-BUILTS

COPYRIGHT 2011
CTA, INC.
ALL RIGHTS RESERVED.
DRAWN BY: Author
CHECKED BY: Checker
DATE: 01/23/12
CTA # MERC




EXISTING
EXTERIOR
ELEVATIONS

SHEET
X201



1 SOUTH
X202 1/8" = 1'-0"

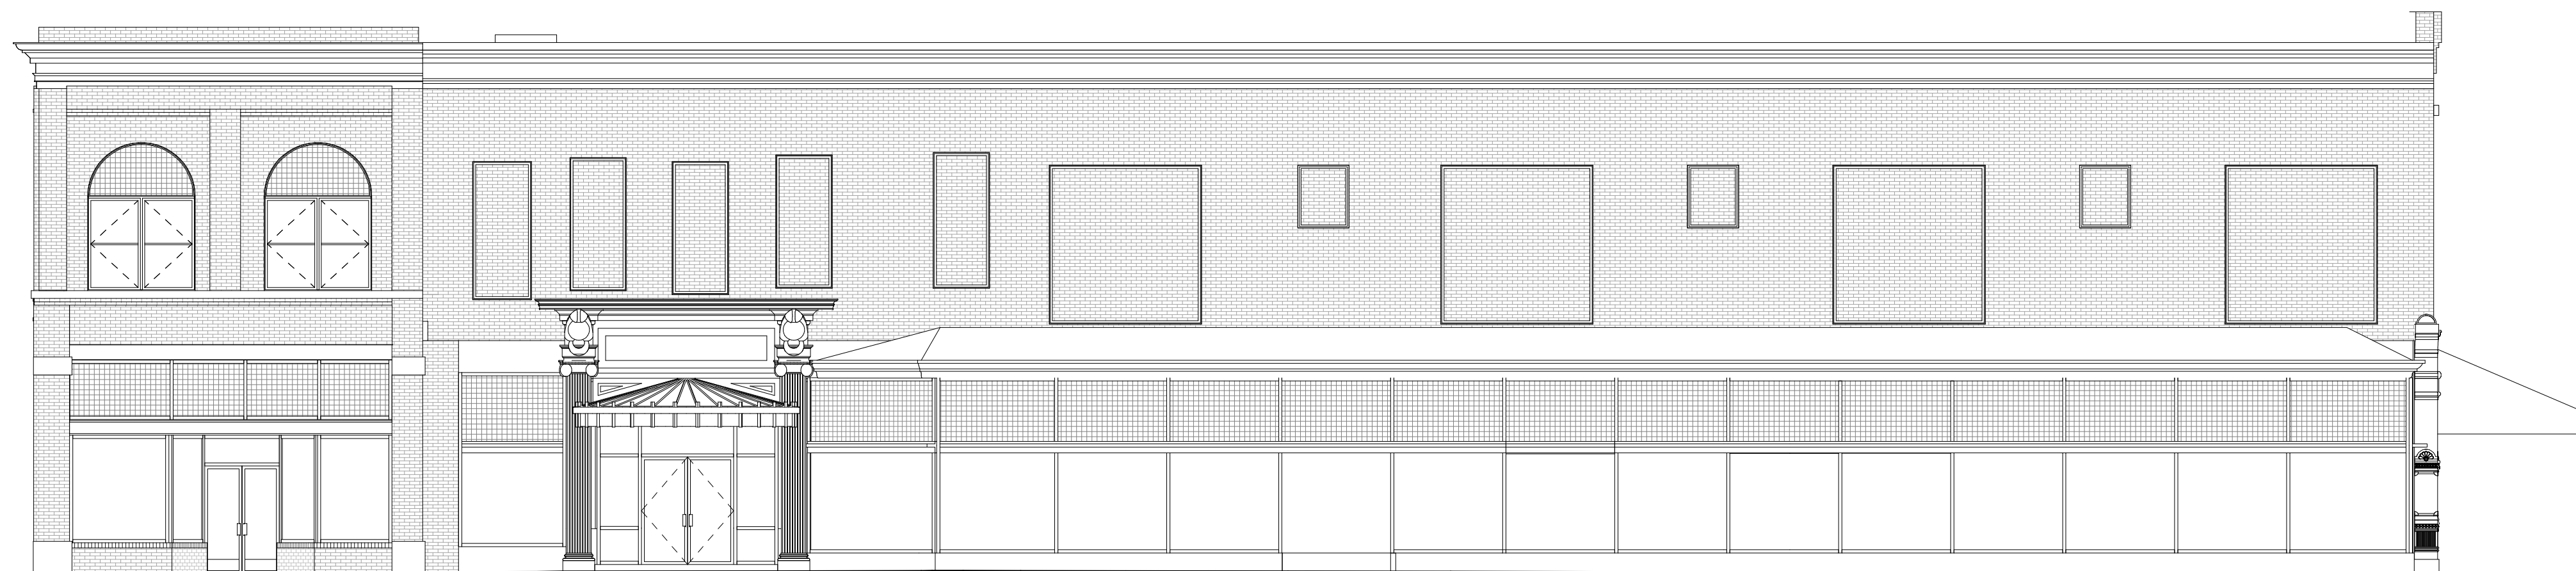

2 WEST
X202 1/8" = 1'-0"

NOT FOR CONSTRUCTION

REVISIONS

A Historical Renovation For:
The Missoula Mercantile Building
110 N. Higgins Ave. Missoula, MT

AS-BUILTS

COPYRIGHT 2011
CTA, INC.
ALL RIGHTS RESERVED.
DRAWN BY: Author
CHECKED BY: Checker
DATE: 01/23/12
CTA # MERC

CTA
EXISTING
EXTERIOR
ELEVATIONS

SHEET
X202